
FORMAL LOBBY (VISITORS) COFFEE GATHERING / LOUNGE BENCH/ RELAXED NOOK SEATING OPEN COLLABORATIVE WALLS QUIET SWING AREA STAFF LOCKERS LIBRARY EXISTING RESTROOMS



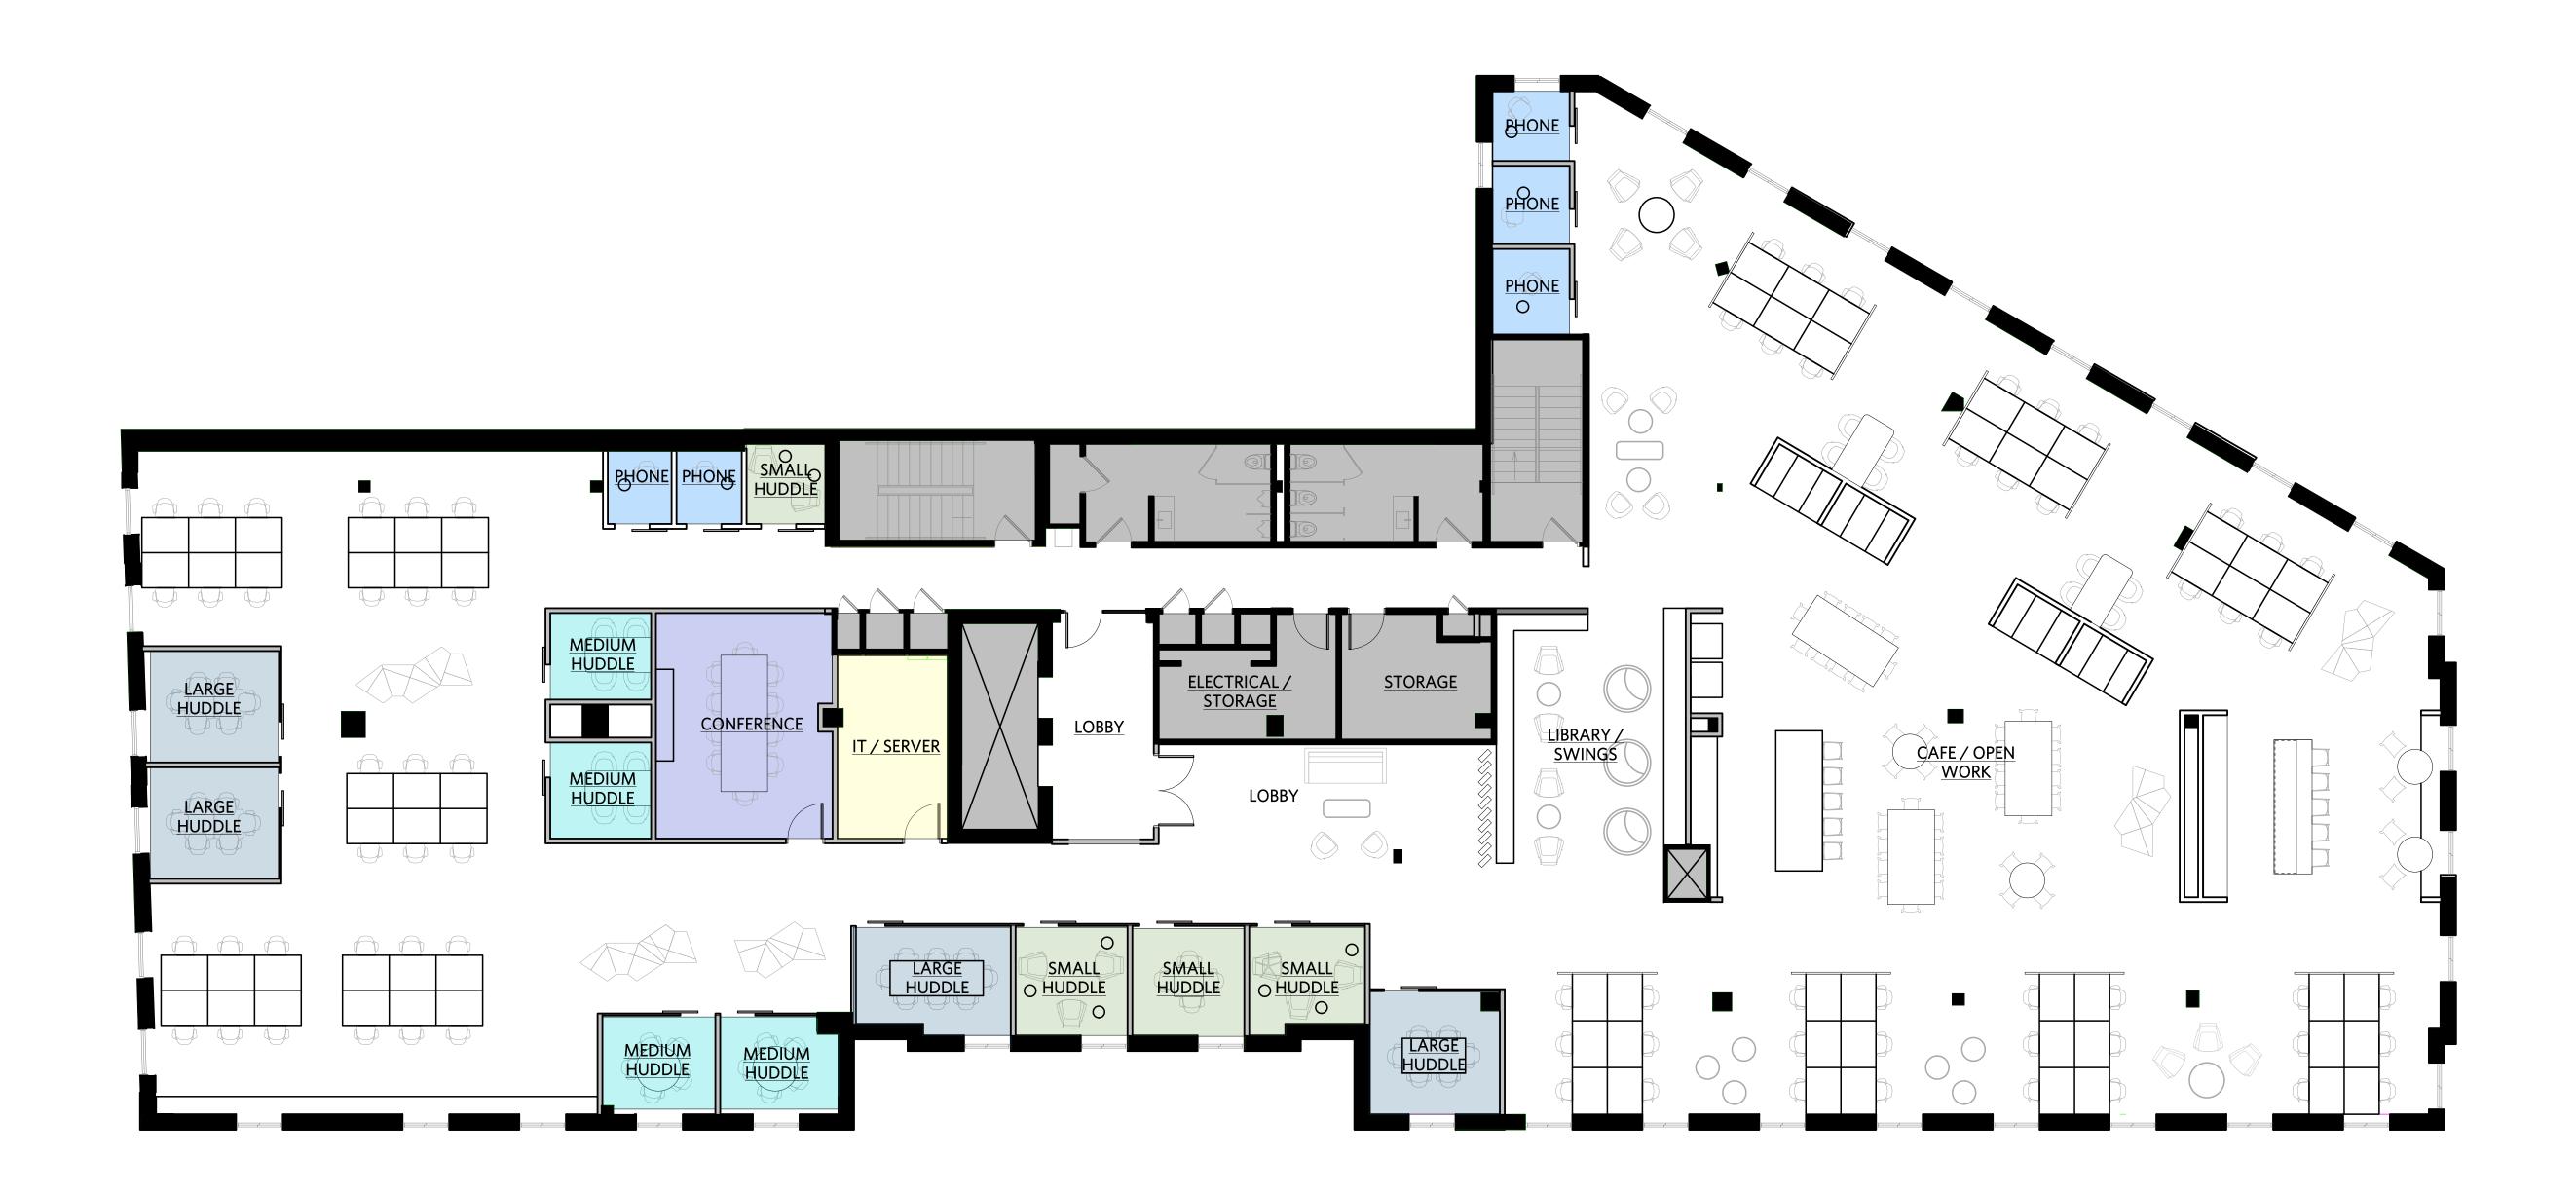

HISTORIC FELLS POINT 1820 LANCASTER SUITE 120 BALTIMORE MD 21231 CLOCKWORK-AD.COM

HISTORIC FELLS POINT 1629 THAMES STREET BALTIMORE MD 21231