


**EXISTING CONDITIONS TENANT FINISH PLAN:**

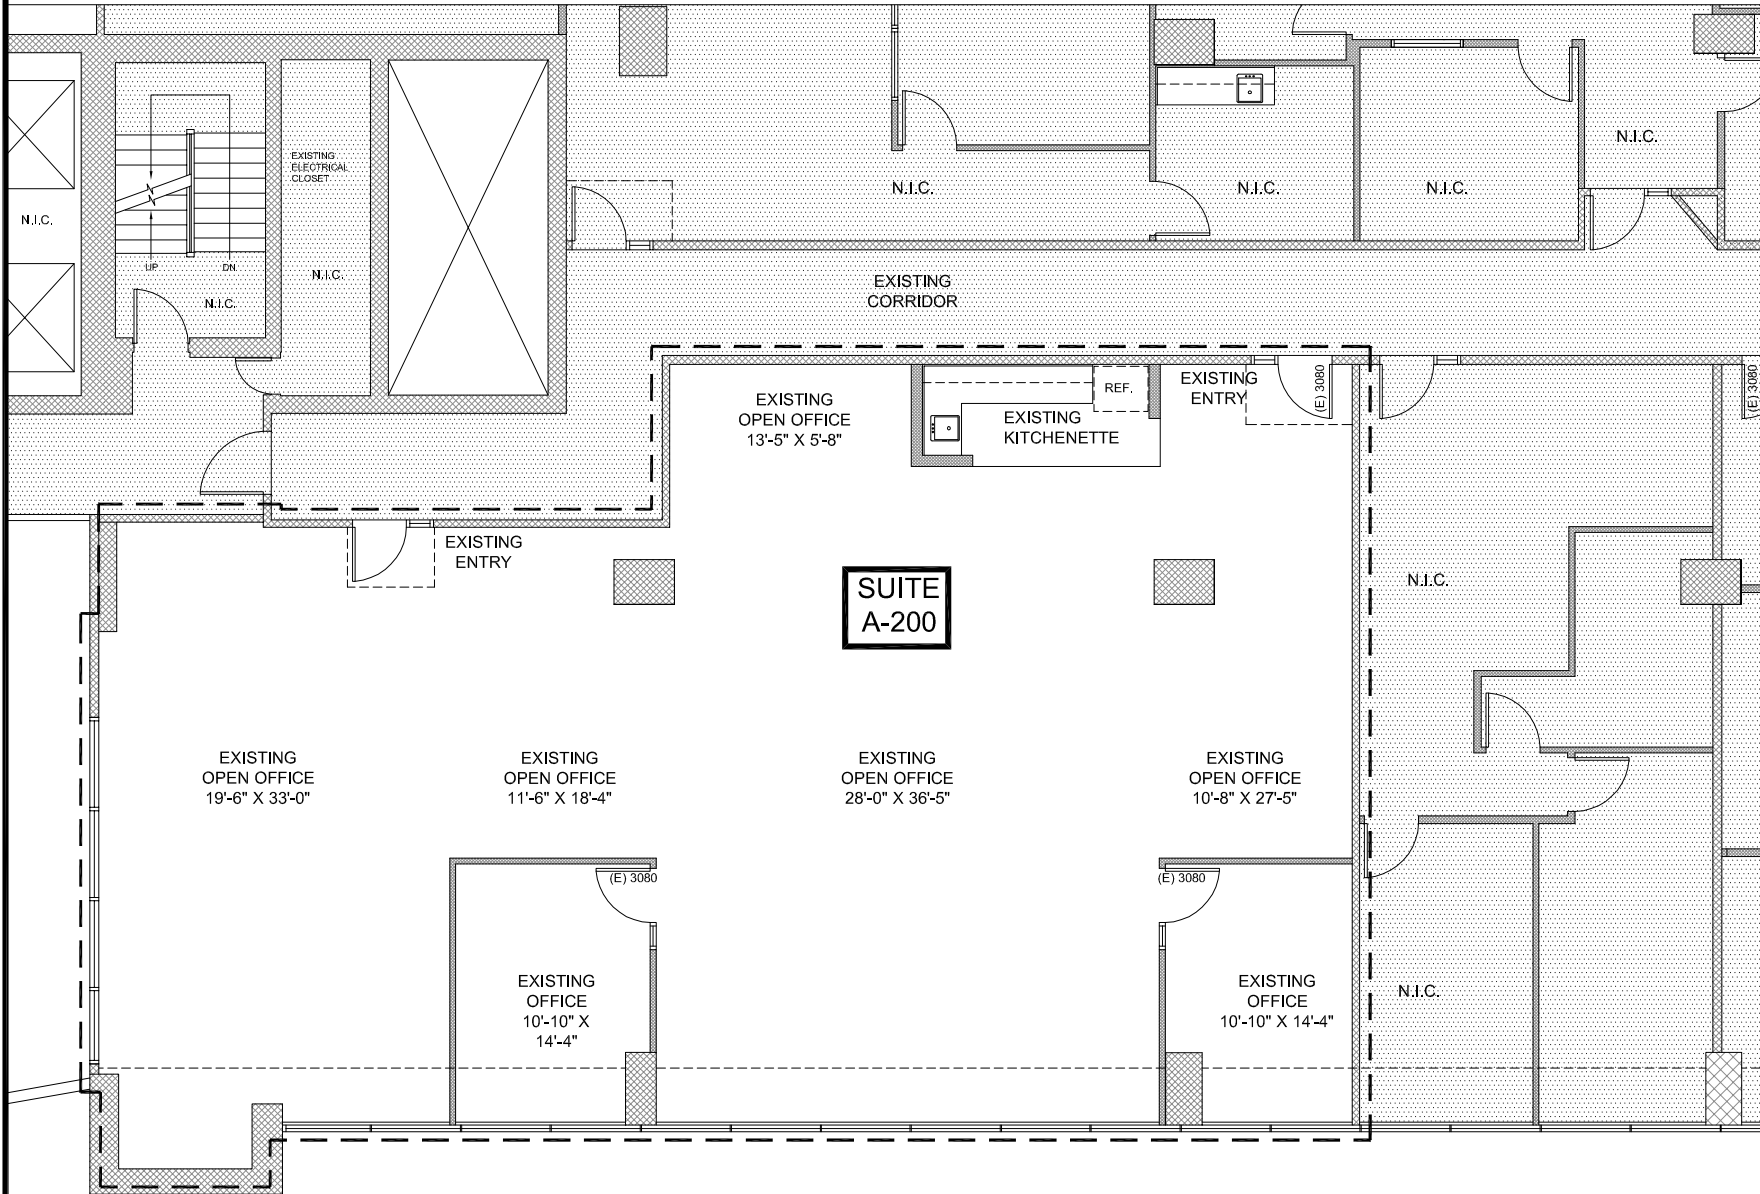

**1** EXISTING A-200's PLAN  
SCALE: 3/32" = 1'-0"

PROPP REALTY MANAGEMENT LLC  
12600 W. COLFAX AVENUE #B-130  
LAKEWOOD, CO 80215  
303-233-4000  
leasing@propprealty.com

BUILDING: 12600 WEST COLFAX AVENUE  
LAKEWOOD COLORADO 80215  
SCOPE: TENANT FINISH BUILDING AS-BUILT DOCUMENTS

EXHIBIT INFO:  
date: 03/20/19  
scale: 3/32" = 1'-0"  
USF: 2,664.6 S.F.  
RSF: 3,064.4 S.F.  
SUITE:

A-200

