




revisions	by

J
 Biagi and Associates
 Engineering, LLC
 555 W Prospect Road
 Oakland Park, FL 33309
 T: 954.776.8004
 F: 954.776.8015
 FL #82591

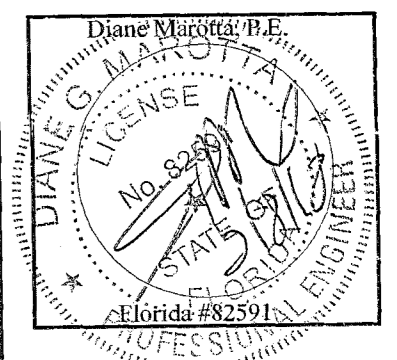

ArchCADD
 Design
 Drafting Service
 1491 NW 20 CT suite B
 FT. Lauderdale, FL 33311
 phone: 954-292-7982
 email: archcadd2@bellsouth.net

The office of ArchCADD Design is solely a "DRAFTING" service only and in NO way is attempting to imply that it is an Architectural or Structural or MEP Engineering firm. All plans are drawn in strict compliance with F.S. 481.229 (EXEMPTIONS FROM LICENSURE). This office is not liable for any work done outside the scope of work outlined in these plans.

WRITTEN DIMENSIONS ON THESE DRAWINGS SHALL HAVE PRECEDENCE OVER SCALE DIMENSIONS. CONTRACTORS SHALL VERIFY AND BE RESPONSIBLE FOR ALL DIMENSIONS AND CONDITIONS ON THE JOB. THIS OFFICE MUST BE NOTIFIED OF ANY VARIATION FROM THE DIMENSIONS AND CONDITIONS SHOWN BY THESE DRAWINGS PRIOR TO CONSTRUCTION. BACKCHARGES WILL NOT BE ACCEPTED.

exist'g floor plan
 SCALE: 1/2" = 1'-0"

Build out for
 Depot
 ral Hwy, FL 33009