

All drawings, specifications, related documents and design are the copyright property of the architect and must be returned upon request. Reproduction of the drawings, specifications, related documents and design in whole or in part is strictly forbidden without the architect's written permission.


This drawing, as an instrument of service, is provided by and is the property of North Office Architects Inc. and shall be used only for the project named on this drawing and solely for reference purposes only. The contractor is responsible for the coordination and verification of all dimensions contained herein and all measurements and conditions on site as they pertain to these documents. The contractor shall report any discrepancies to the consultant in writing prior to the commencement of any affected work.

DO NOT SCALE THIS DRAWING
This drawing shall not be used for construction purposes unless countersigned.
North Office Architects Inc.

NOT FOR CONSTRUCTION UNTIL PERMIT ISSUANCE.

REV	DATE	ISSUED FOR
1	12-12-22	AS BUILT


AREA TABLE				
UNIT	BM	GF	2F	TOTAL
170	794	1566	1795	4155 SF
172	1421	1684	1554	4659 SF
174	1428	1322	1382	4132 SF
176	1661	1740	1681	5082 SF

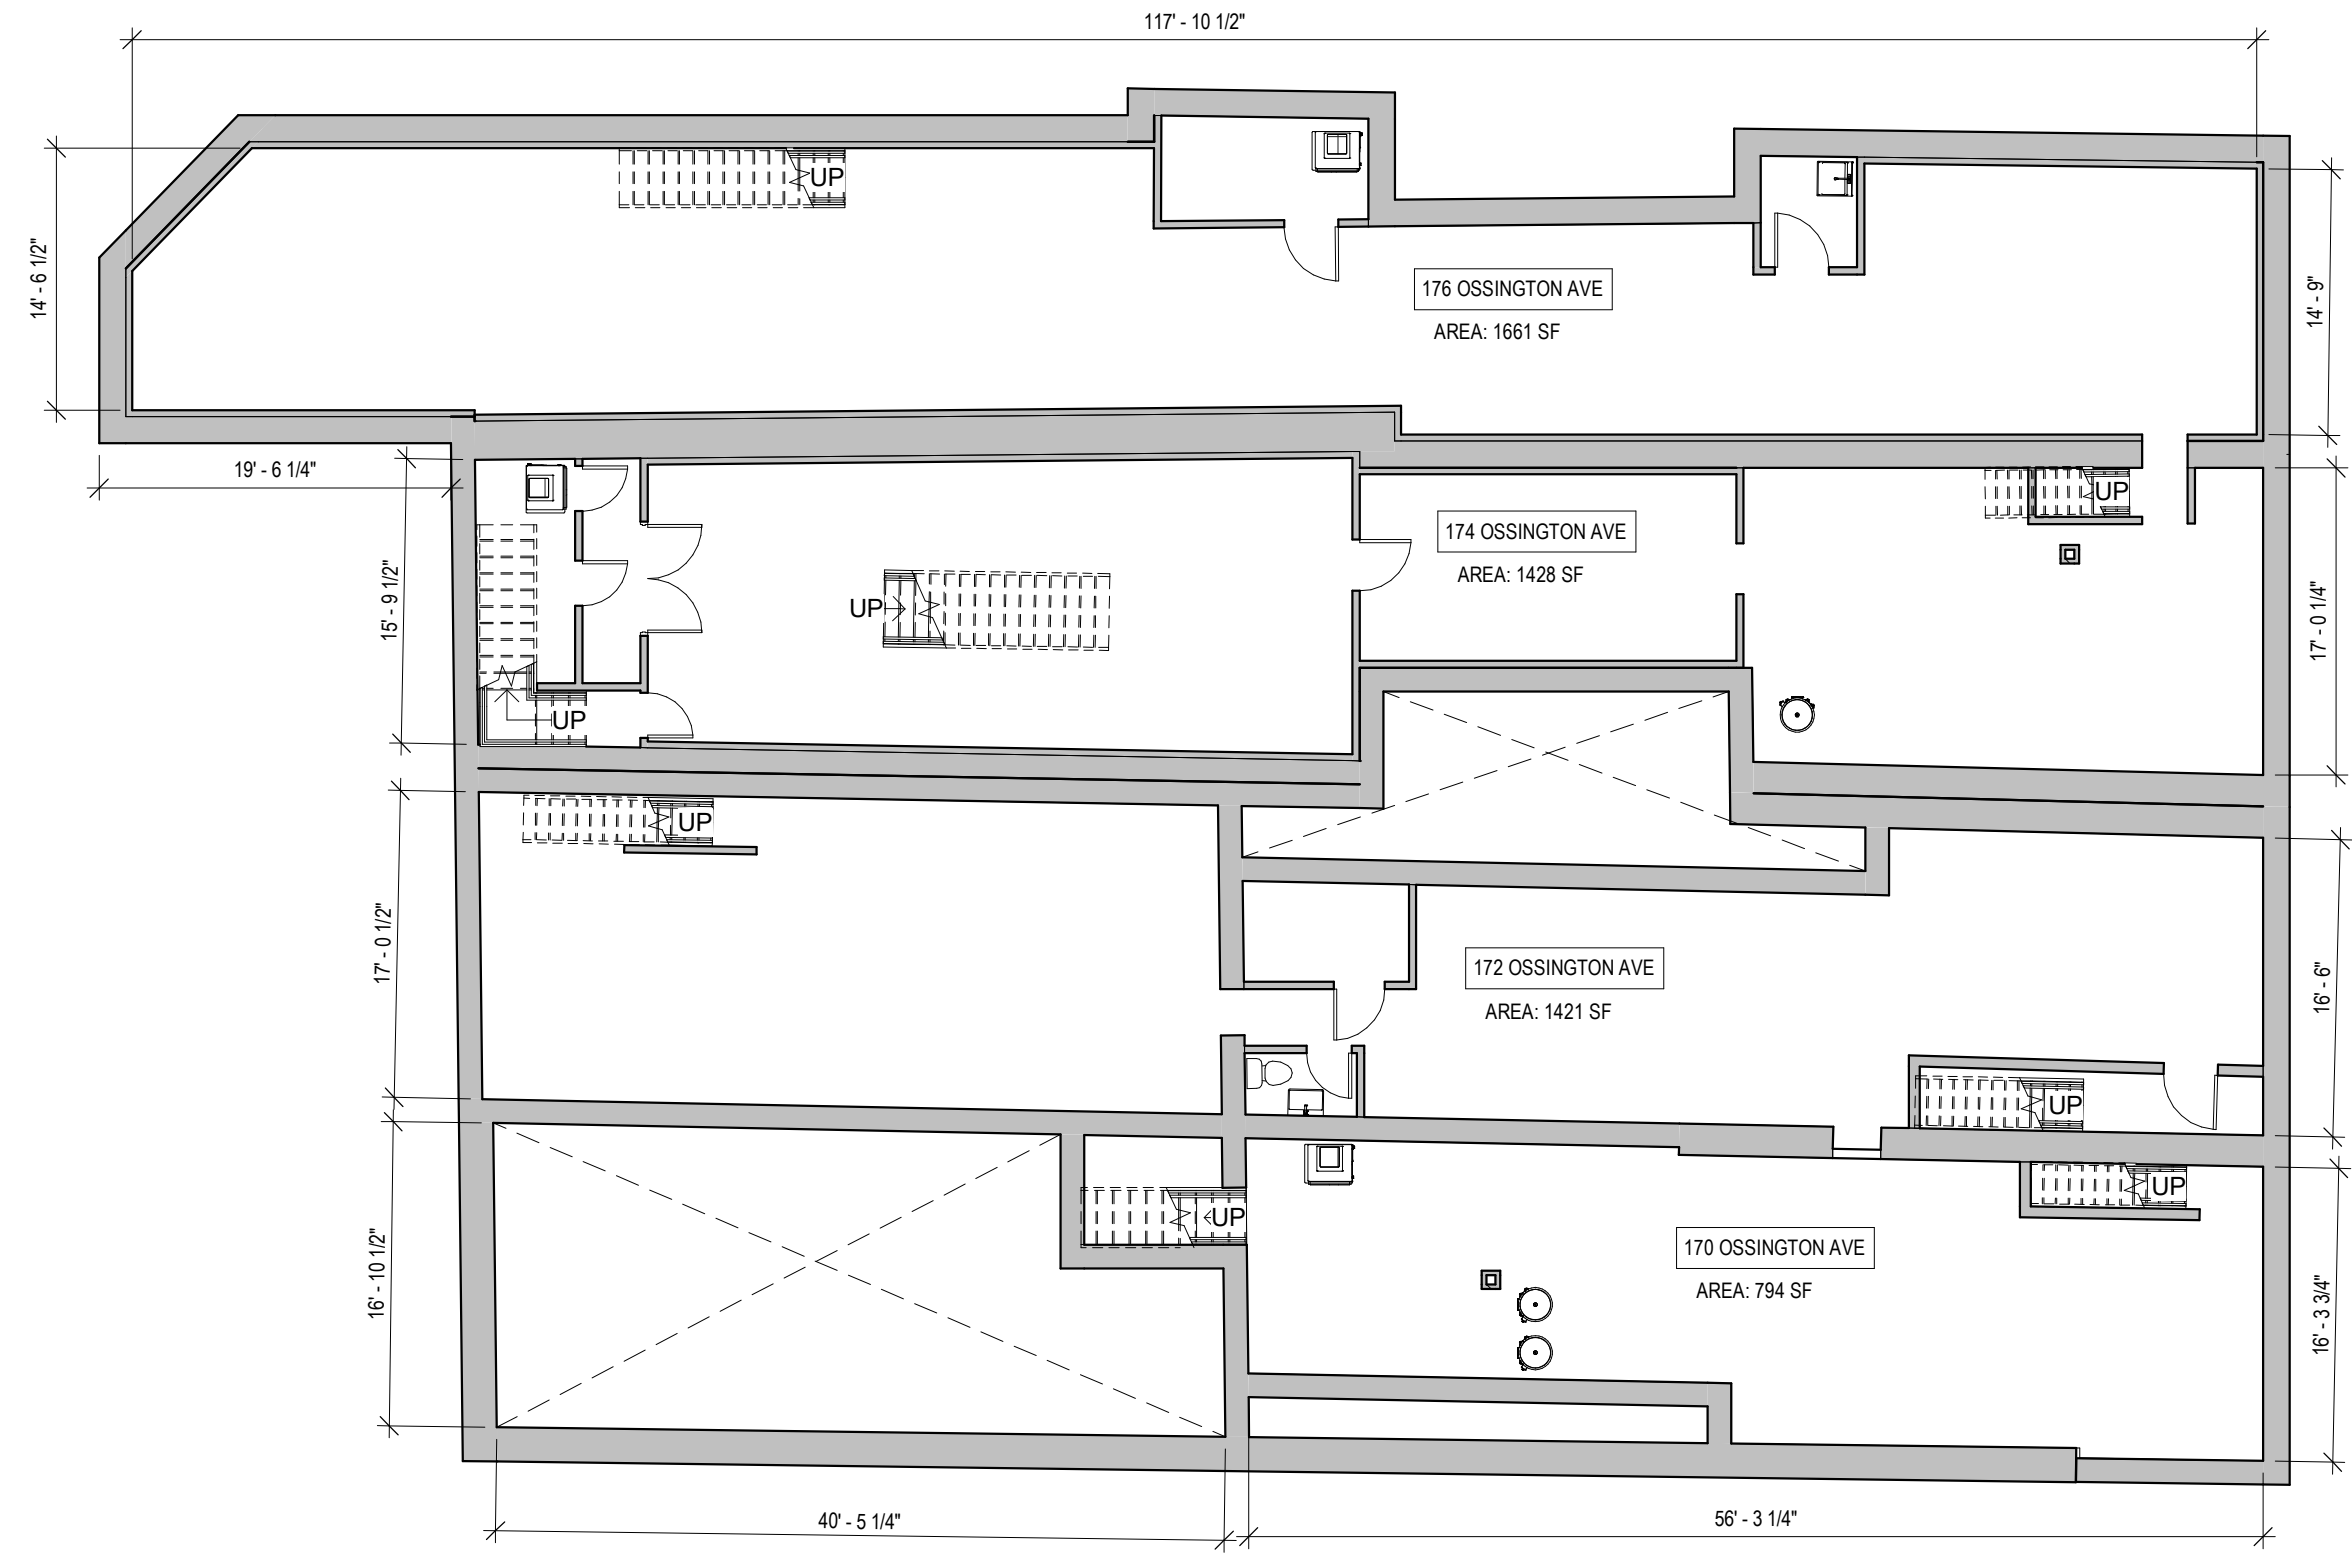

170-176 OSSINGTON
170-176 OSSINGTON AVE, TORONTO, ON M6J 2Z7



PROJ NO 2130
SCALE 3/32" = 1'-0"
DRAWN BY NOA
REVIEWED BY LC

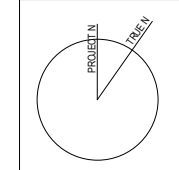

BM PLAN
A8.1

All drawings, specifications, related documents and design are the copyright property of the architect and must be returned upon request. Reproduction of the drawings, specifications, related documents and design in whole or in part is strictly forbidden without the architect's written permission.


This drawing, as an instrument of service, is provided by and is the property of North Office Architects Inc. and shall be used only for the project named on this drawing and solely for reference purposes only. The contractor is responsible for the coordination and verification of all dimensions contained herein and all measurements and conditions on site as they pertain to these documents. The contractor shall report any discrepancies to the consultant in writing prior to the commencement of any affected work.

DO NOT SCALE THIS DRAWING
This drawing shall not be used for construction purposes unless countersigned.

North Office Architects Inc.
NOT FOR CONSTRUCTION UNTIL PERMIT ISSUANCE.

REV	DATE	ISSUED FOR
1	12-12-22	AS BUILT

AREA TABLE				
UNIT	BM	GF	2F	TOTAL
170	794	1566	1795	4155 SF
172	1421	1684	1554	4659 SF
174	1428	1322	1382	4132 SF
176	1661	1740	1681	5082 SF

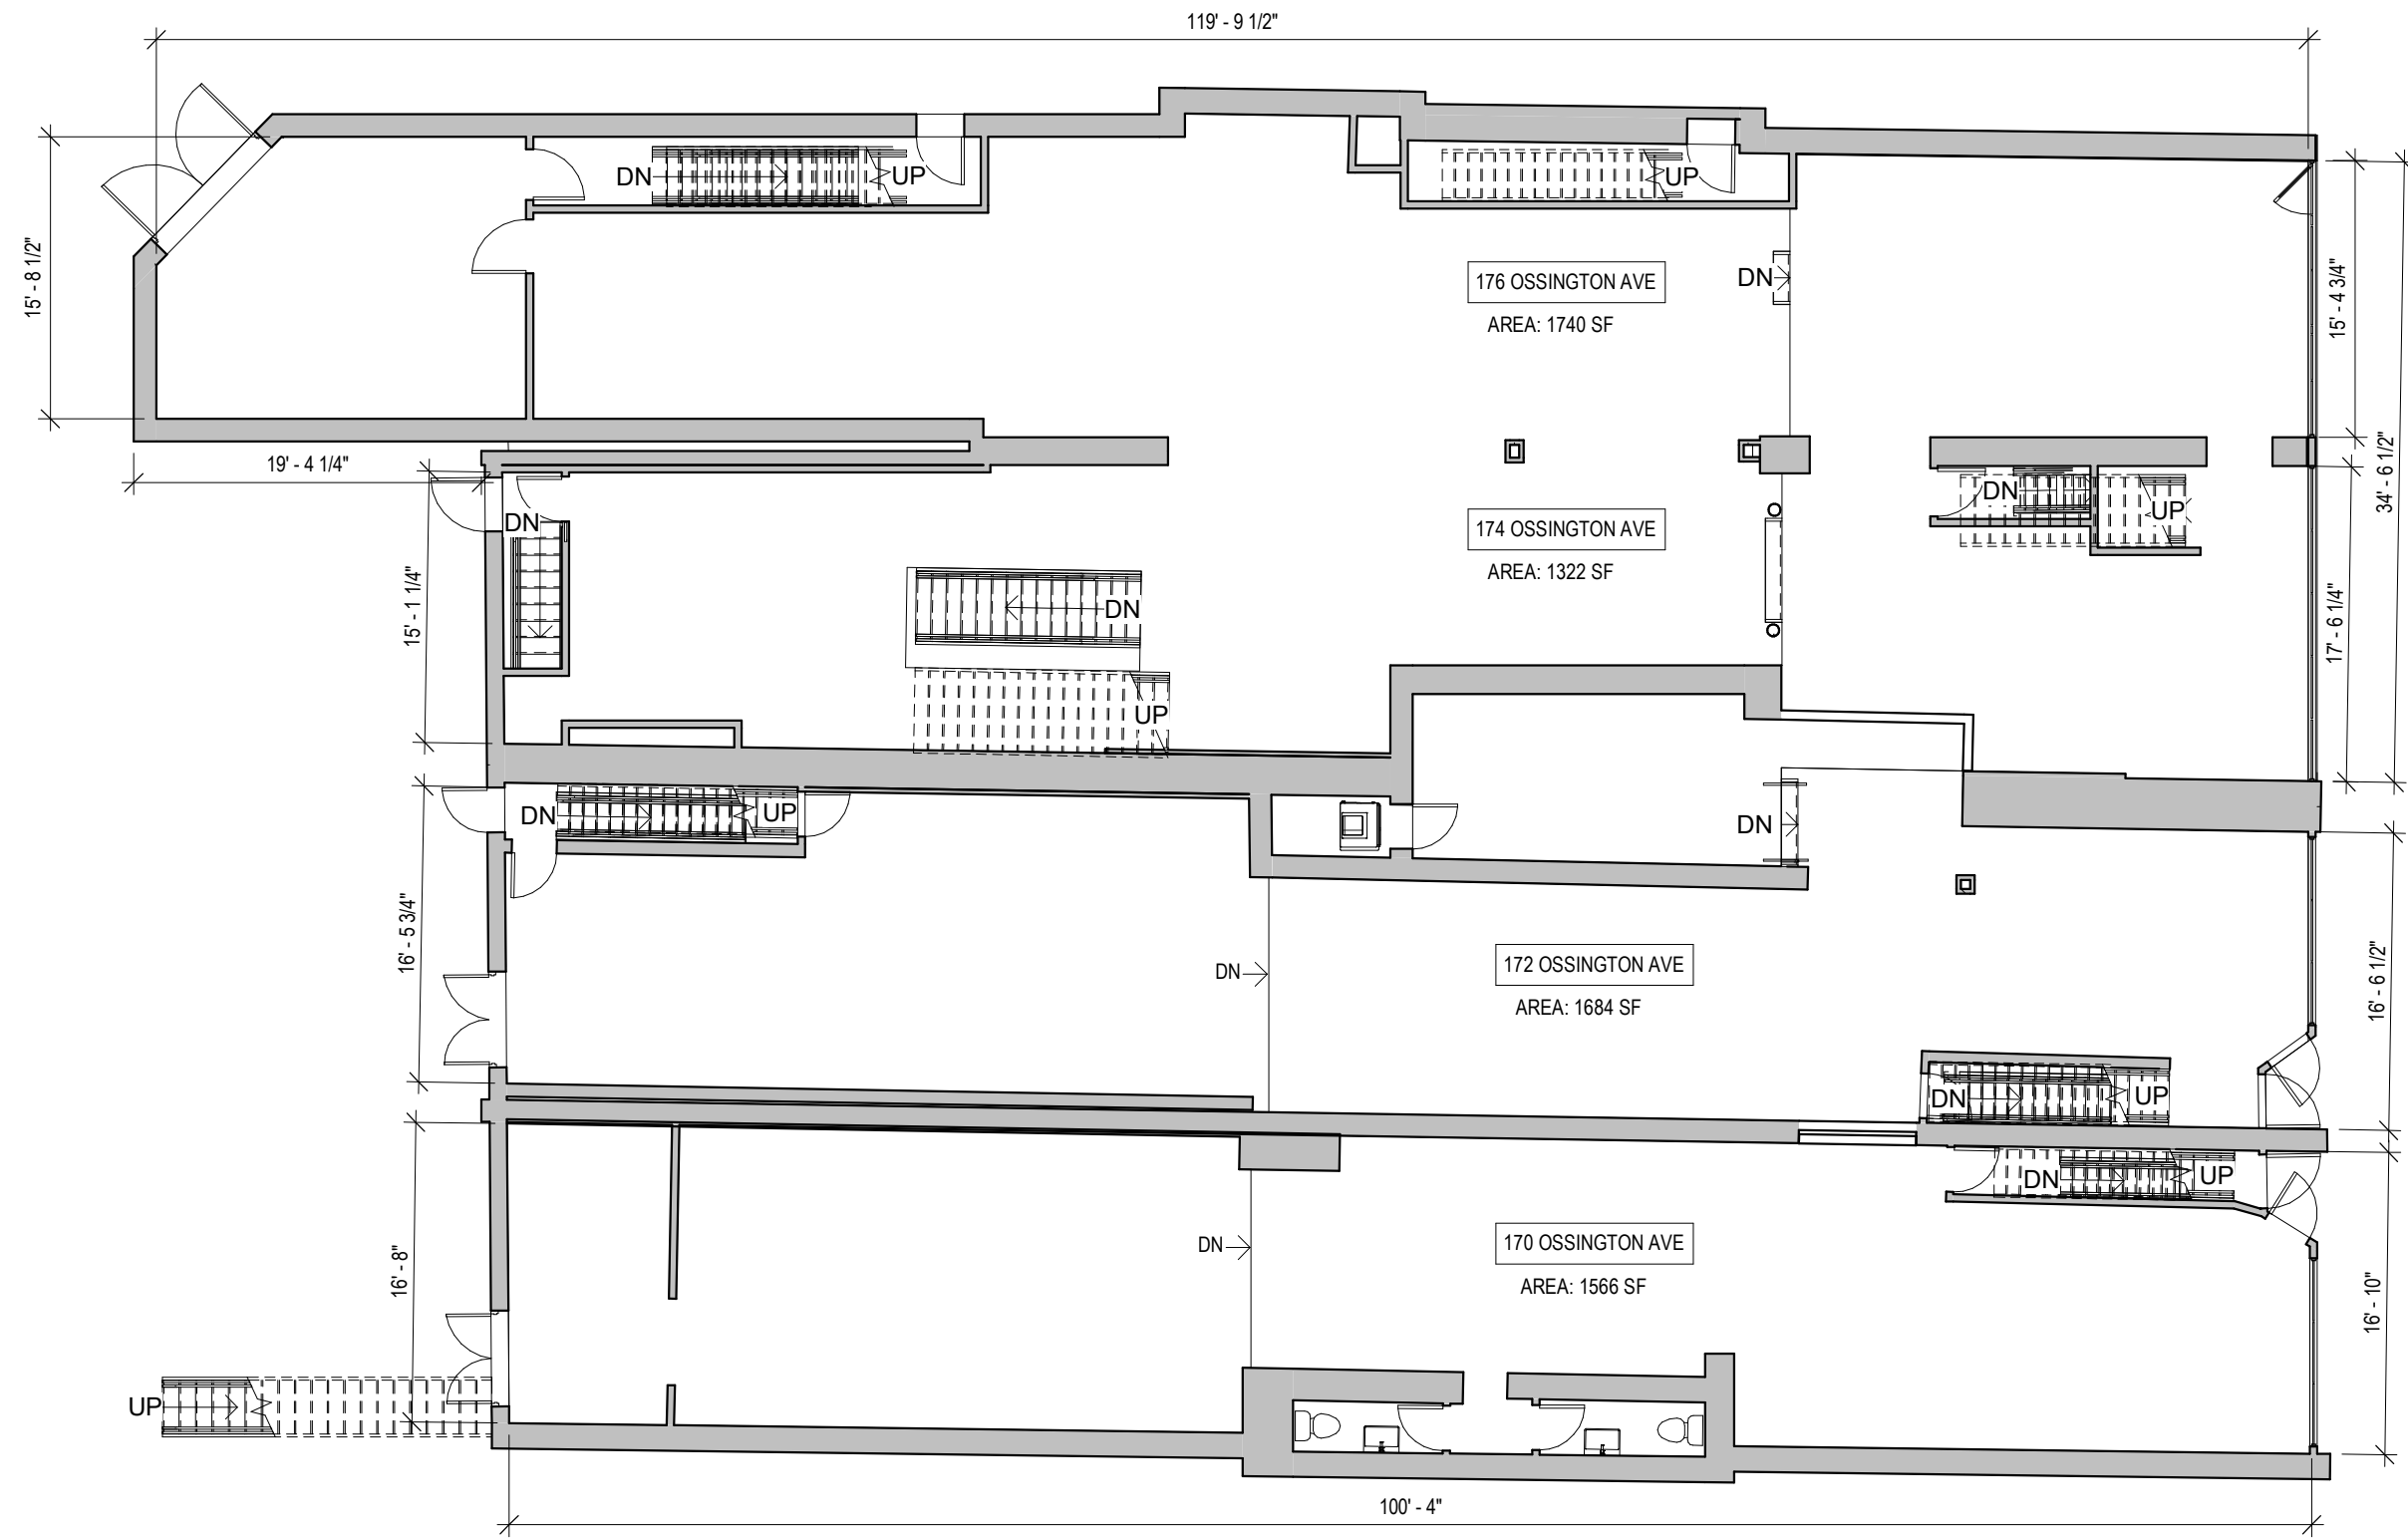


OSSINGTON AVENUE

170-176 OSSINGTON
170-176 OSSINGTON AVE, TORONTO, ON M6J 2Z7



PROJ NO 2130
SCALE 3/32" = 1'-0"
DRAWN BY NOA
REVIEWED BY LC

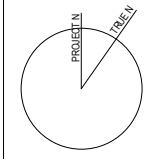

GF PLAN
A8.2

All drawings, specifications, related documents and design are the copyright property of the architect and must be returned upon request. Reproduction of the drawings, specifications, related documents and design in whole or in part is strictly forbidden without the architect's written permission.


This drawing, as an instrument of service, is provided by and is the property of North Office Architects Inc. and shall be used only for the project named on this drawing and solely for reference purposes only. The contractor is responsible for the coordination and verification of all dimensions contained herein and all measurements and conditions on site as they pertain to these documents. The contractor shall report any discrepancies to the consultant in writing prior to the commencement of any affected work.

DO NOT SCALE THIS DRAWING
This drawing shall not be used for construction purposes unless countersigned.
North Office Architects Inc.

NOT FOR CONSTRUCTION UNTIL PERMIT ISSUANCE.

REV	DATE	ISSUED FOR
1	12-12-22	AS BUILT

AREA TABLE				
UNIT	BM	GF	2F	TOTAL
170	794	1566	1795	4155 SF
172	1421	1684	1554	4659 SF
174	1428	1322	1382	4132 SF
176	1661	1740	1681	5082 SF

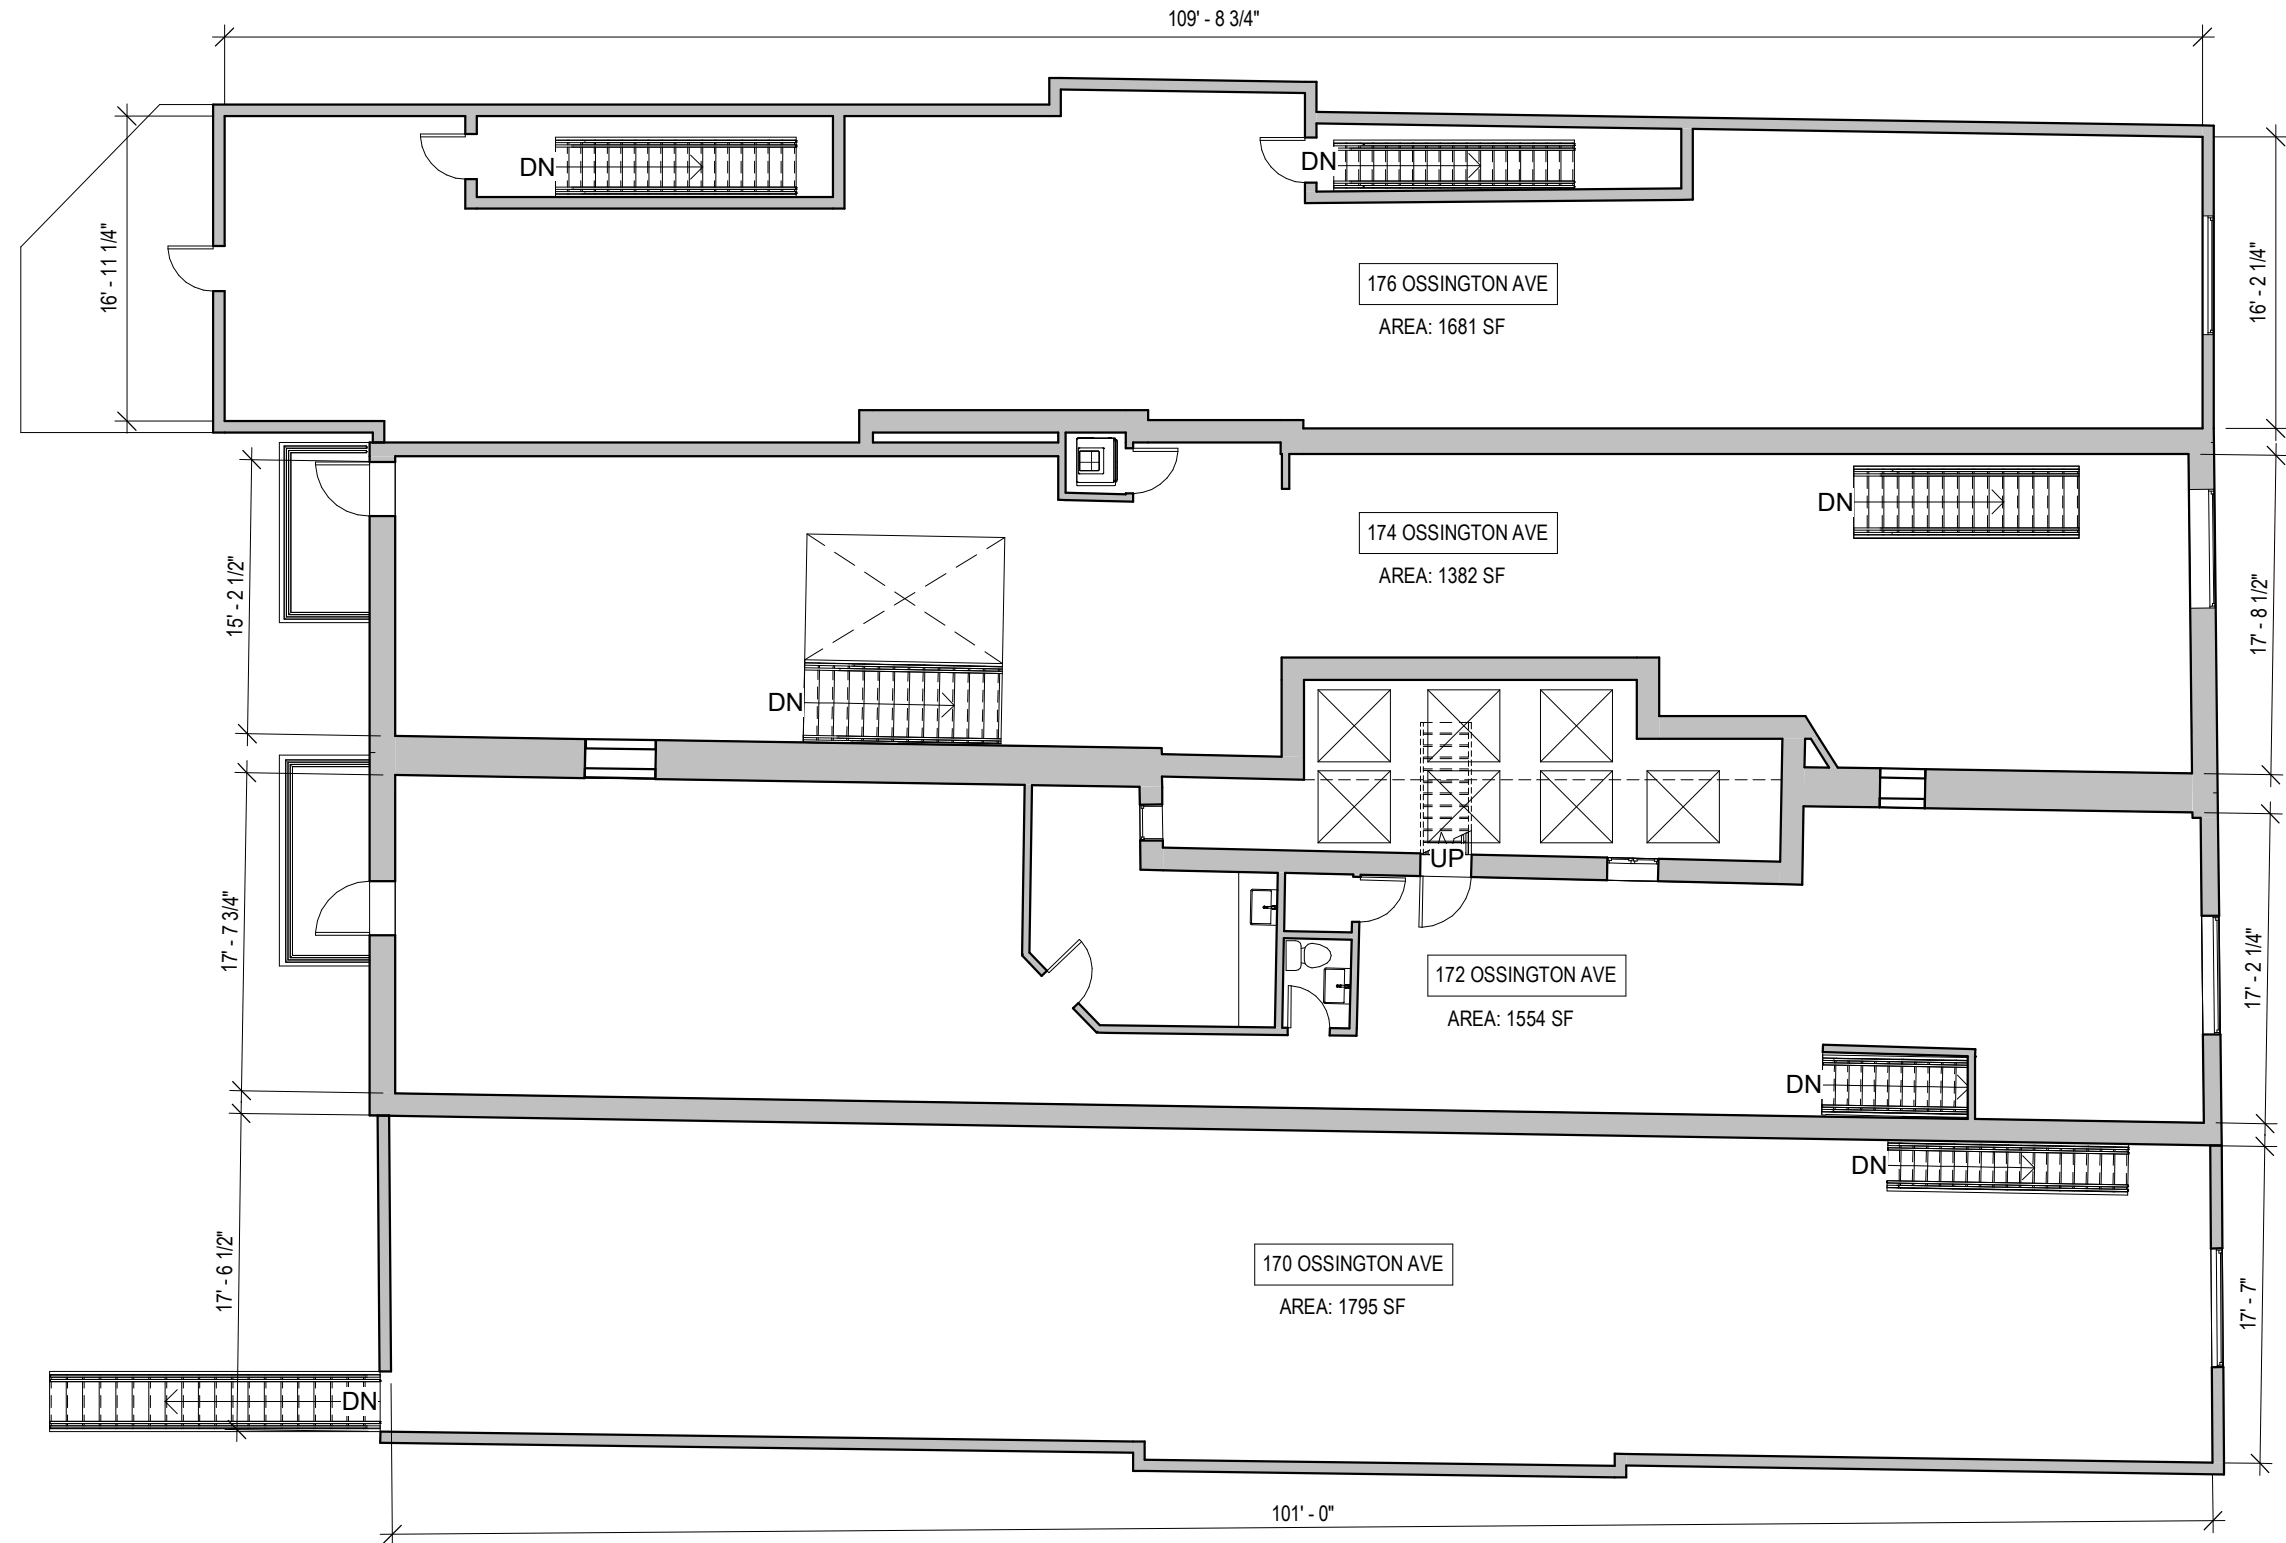


OSSINGTON AVENUE

170-176 OSSINGTON
170-176 OSSINGTON AVE, TORONTO, ON M6J 2Z7



PROJ NO	2130
SCALE	3/32" = 1'-0"
DRAWN BY	NOA
REVIEWED BY	LC

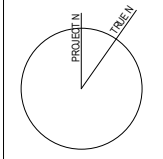

2F PLAN
A8.3