


7107 East Southern Avenue

Mesa . Arizona

Suite 101 - 4,324 SF

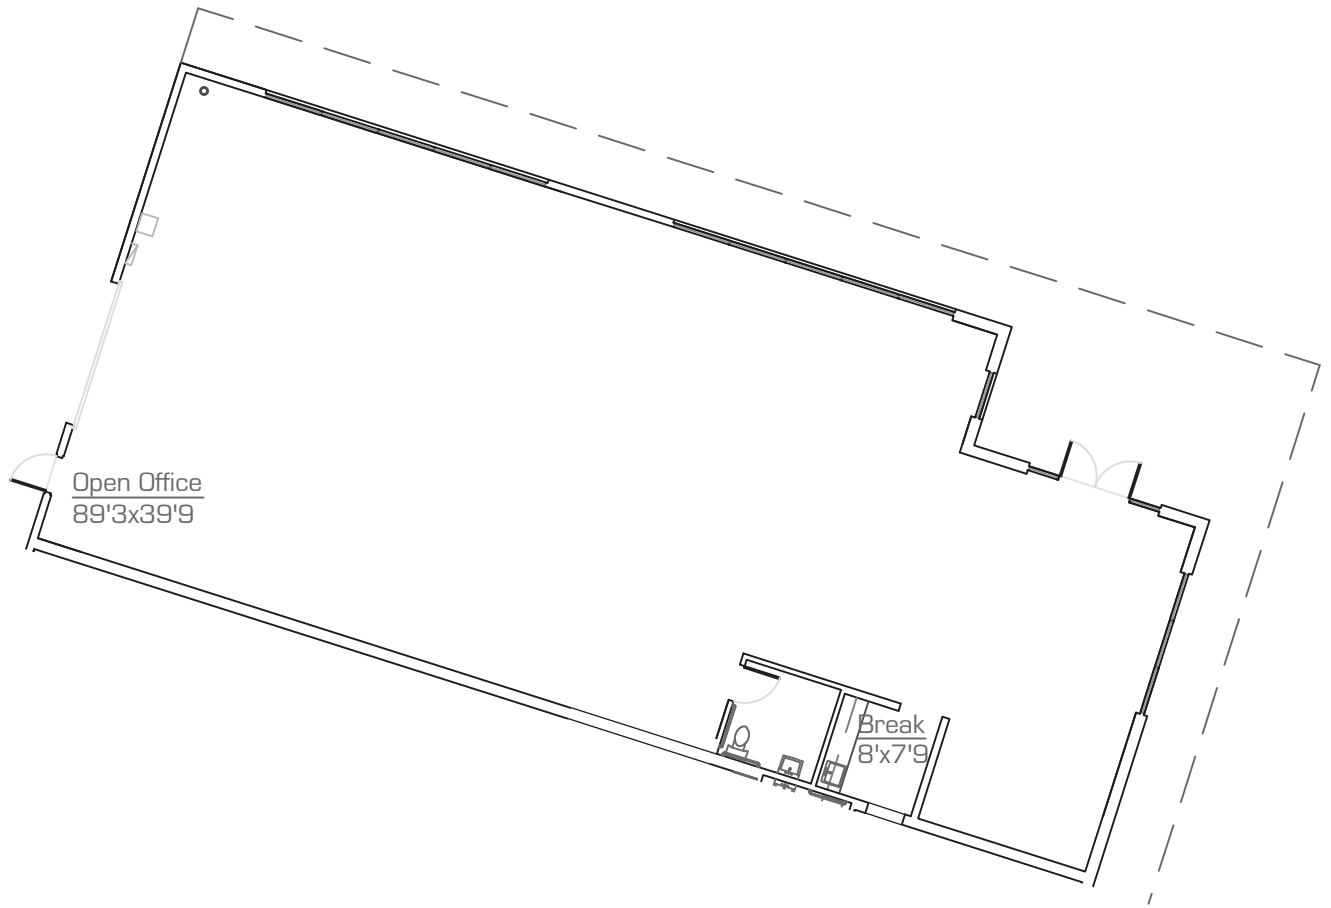

Space Plan A

scale: nts

27.July.2022

\*All dimensions are approximate at ± 3"

\*All information is of general nature

precisionDIMENSIONS

as-built & design

602.790.6412

