


FIRST FLOOR P L A N

SCALE: 1/4" = 1' - 0"

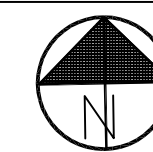

REVISED / DATE

THIS DOCUMENT REPRESENTS A PROPRIETARY DESIGN OWNED BY THE ARCHITECT AND SHALL NOT BE USED ON OTHER PROJECTS FOR ADDITIONS TO THIS PROJECT OR FOR COMPLETION OF THIS PROJECT BY OTHERS EXCEPT BY PRIOR AGREEMENT IN WRITING.

DATE	JOB NO.
08/30/02	01.15

